
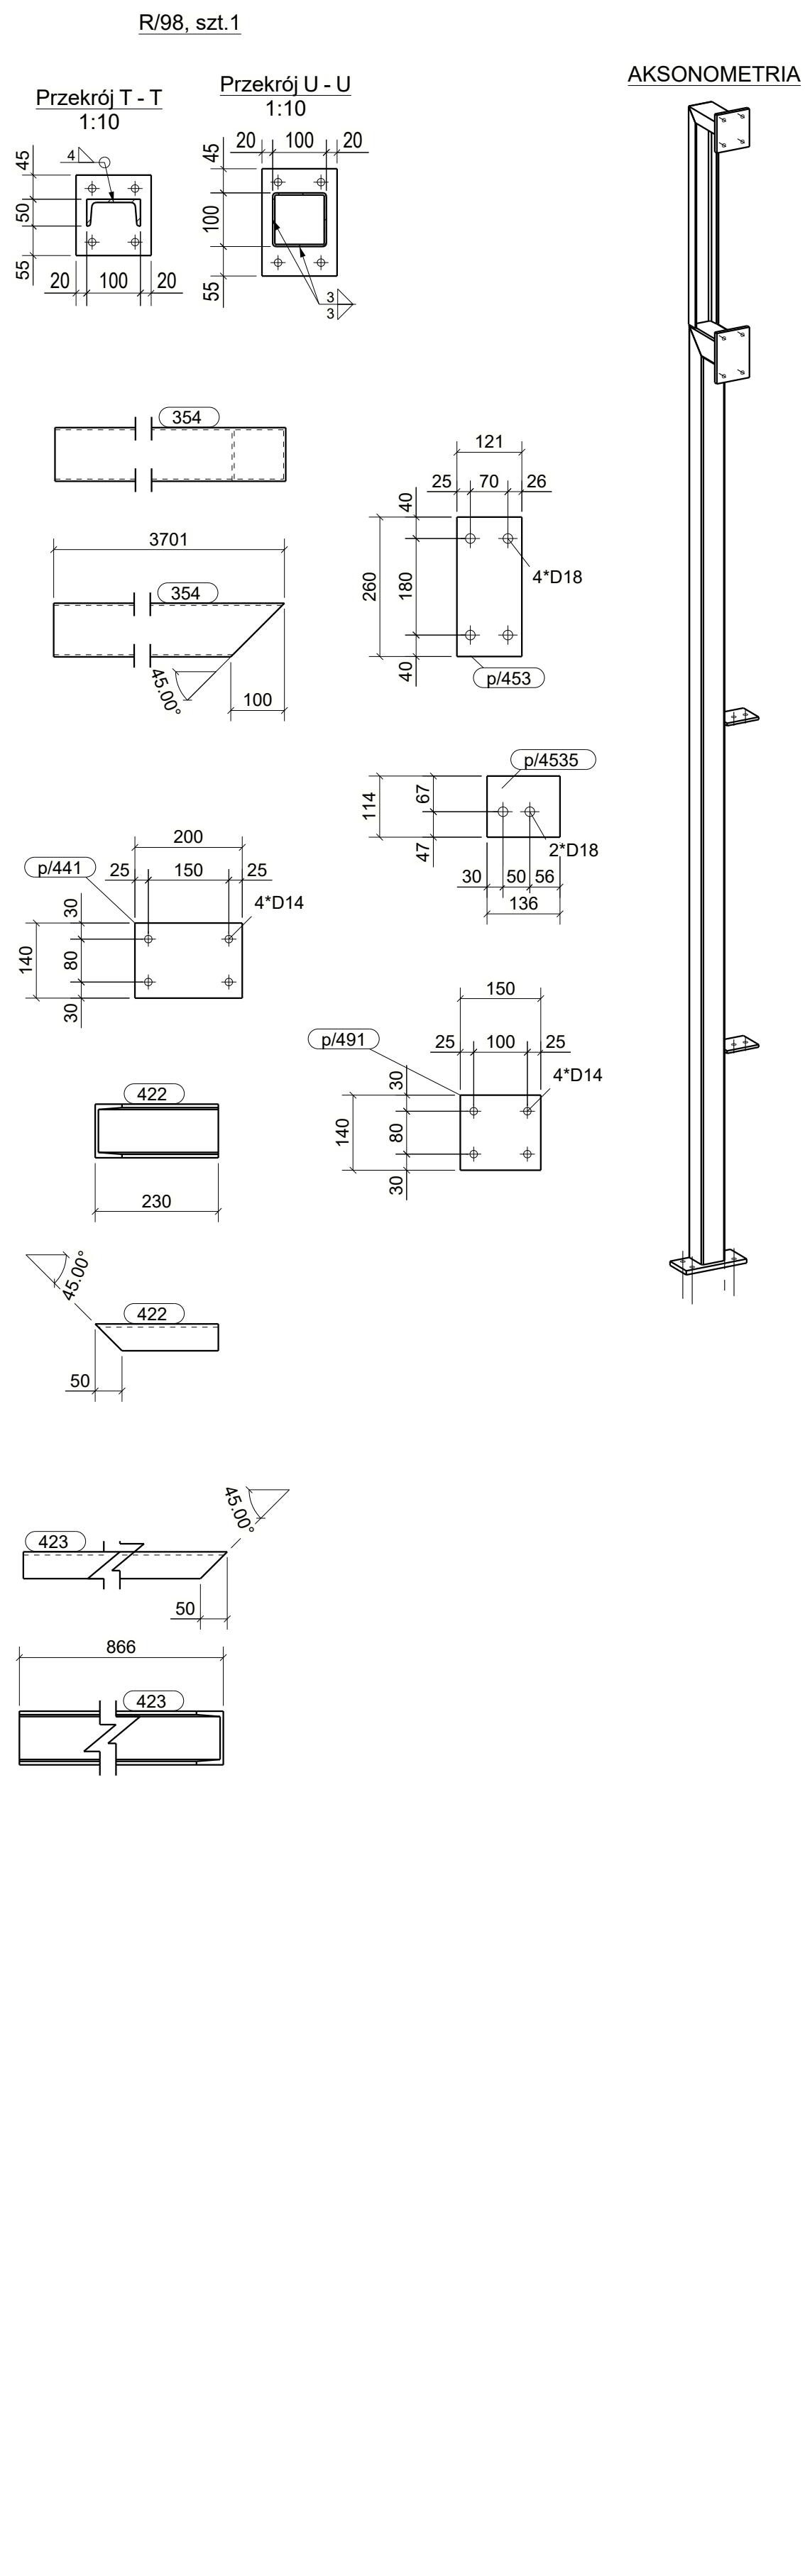
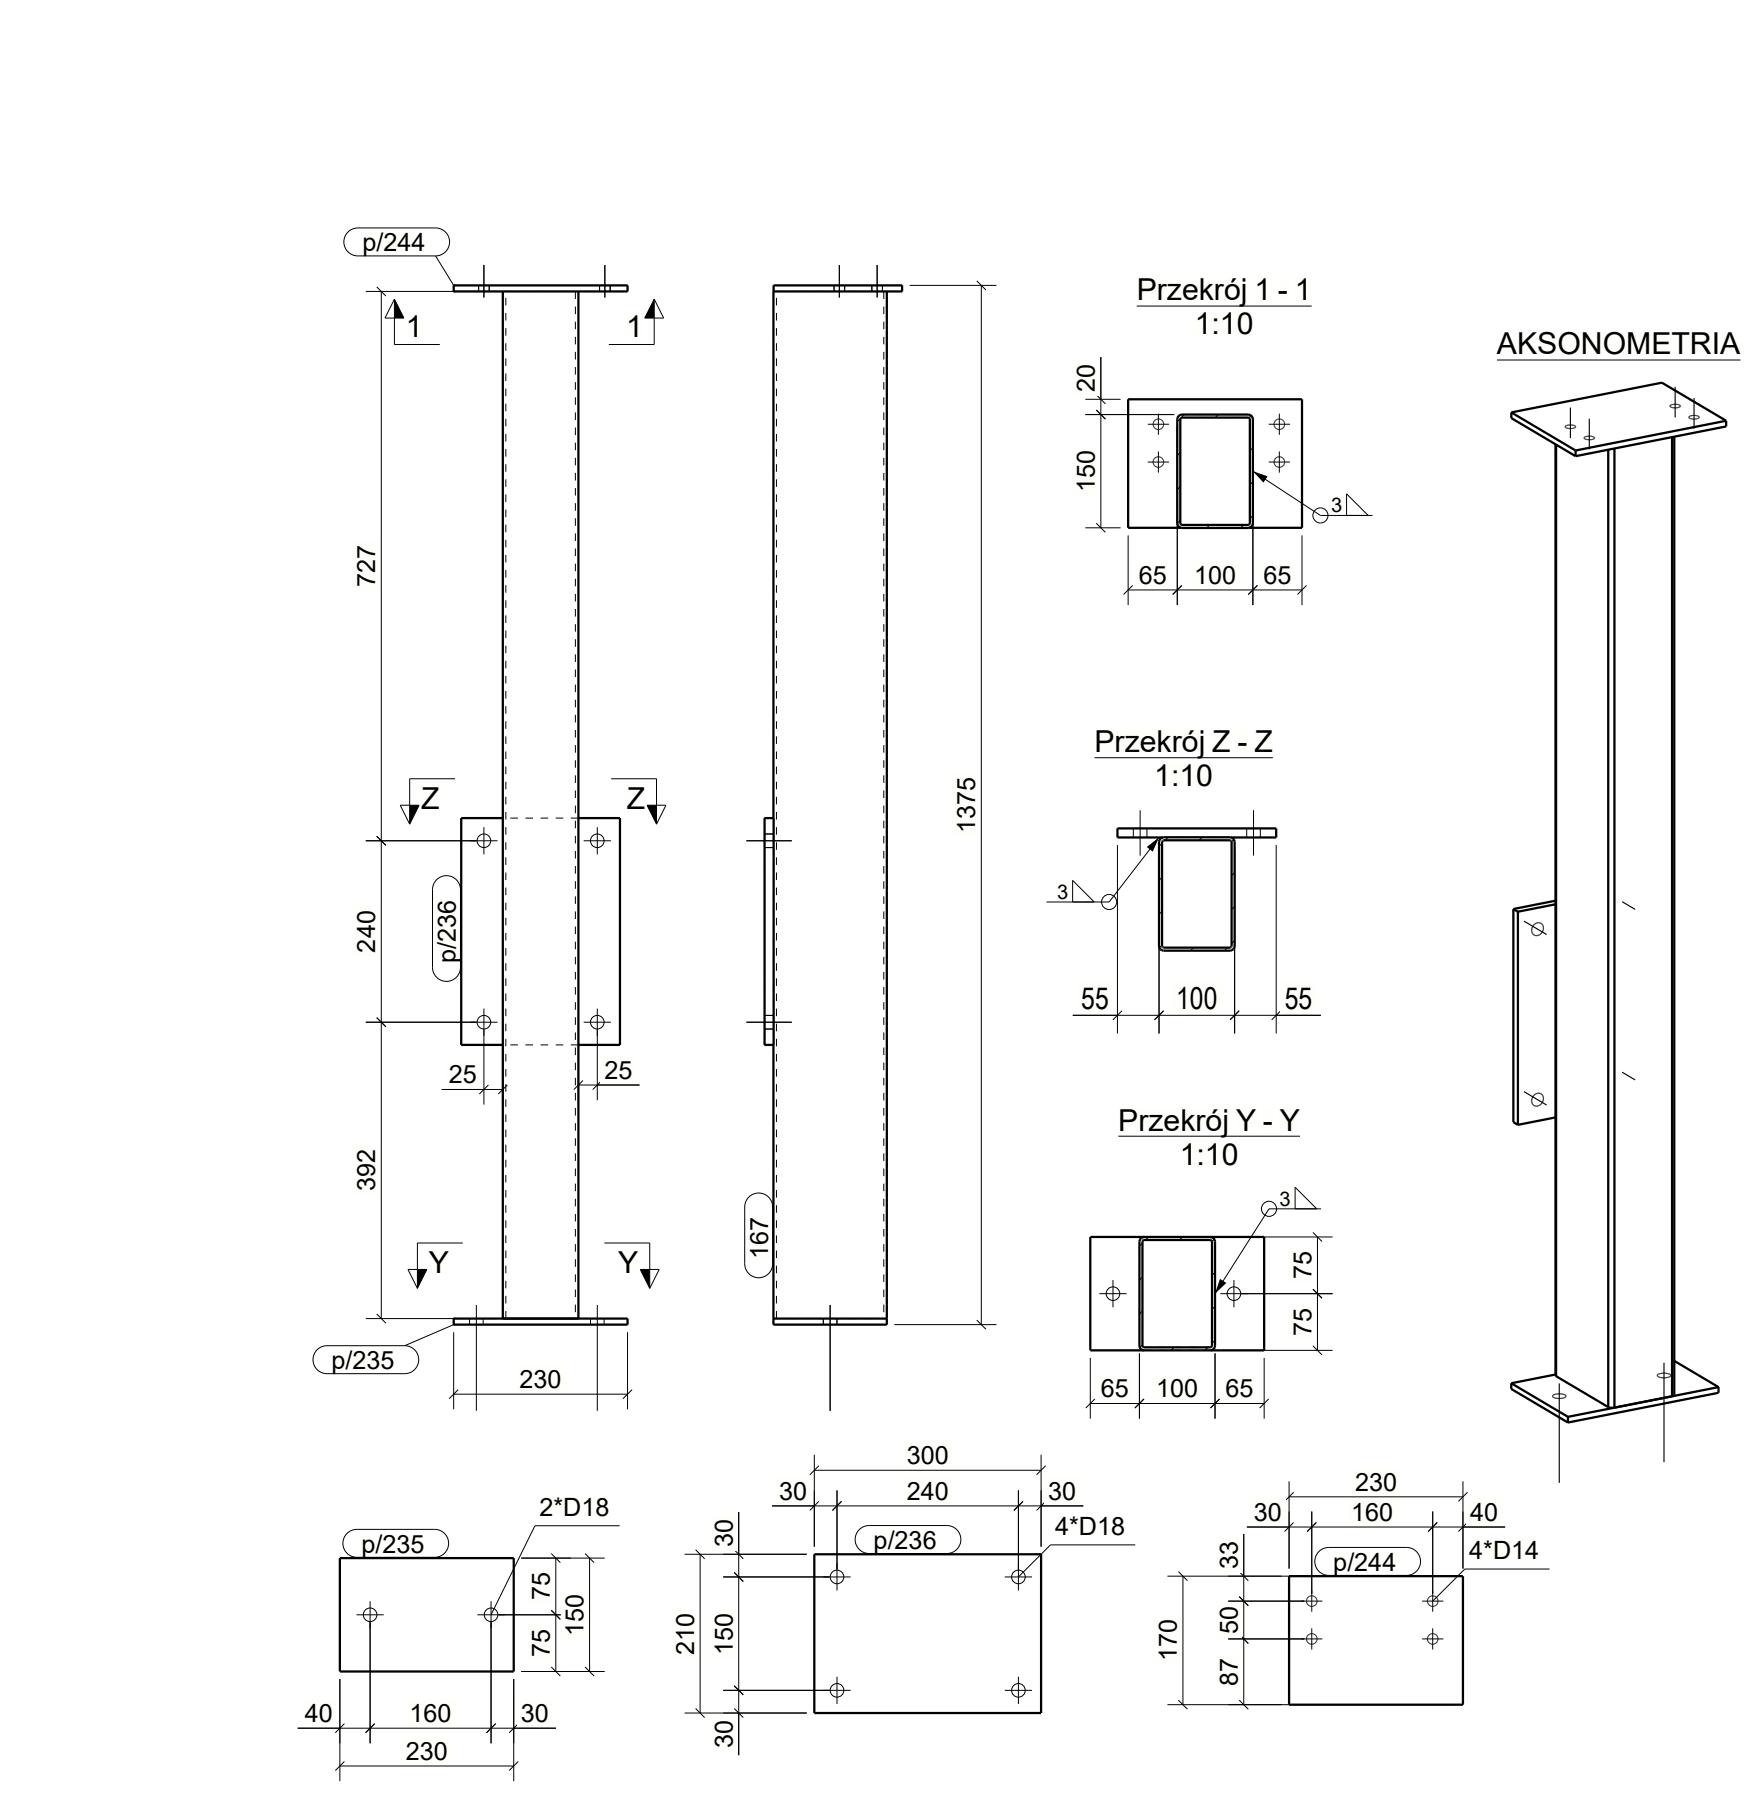
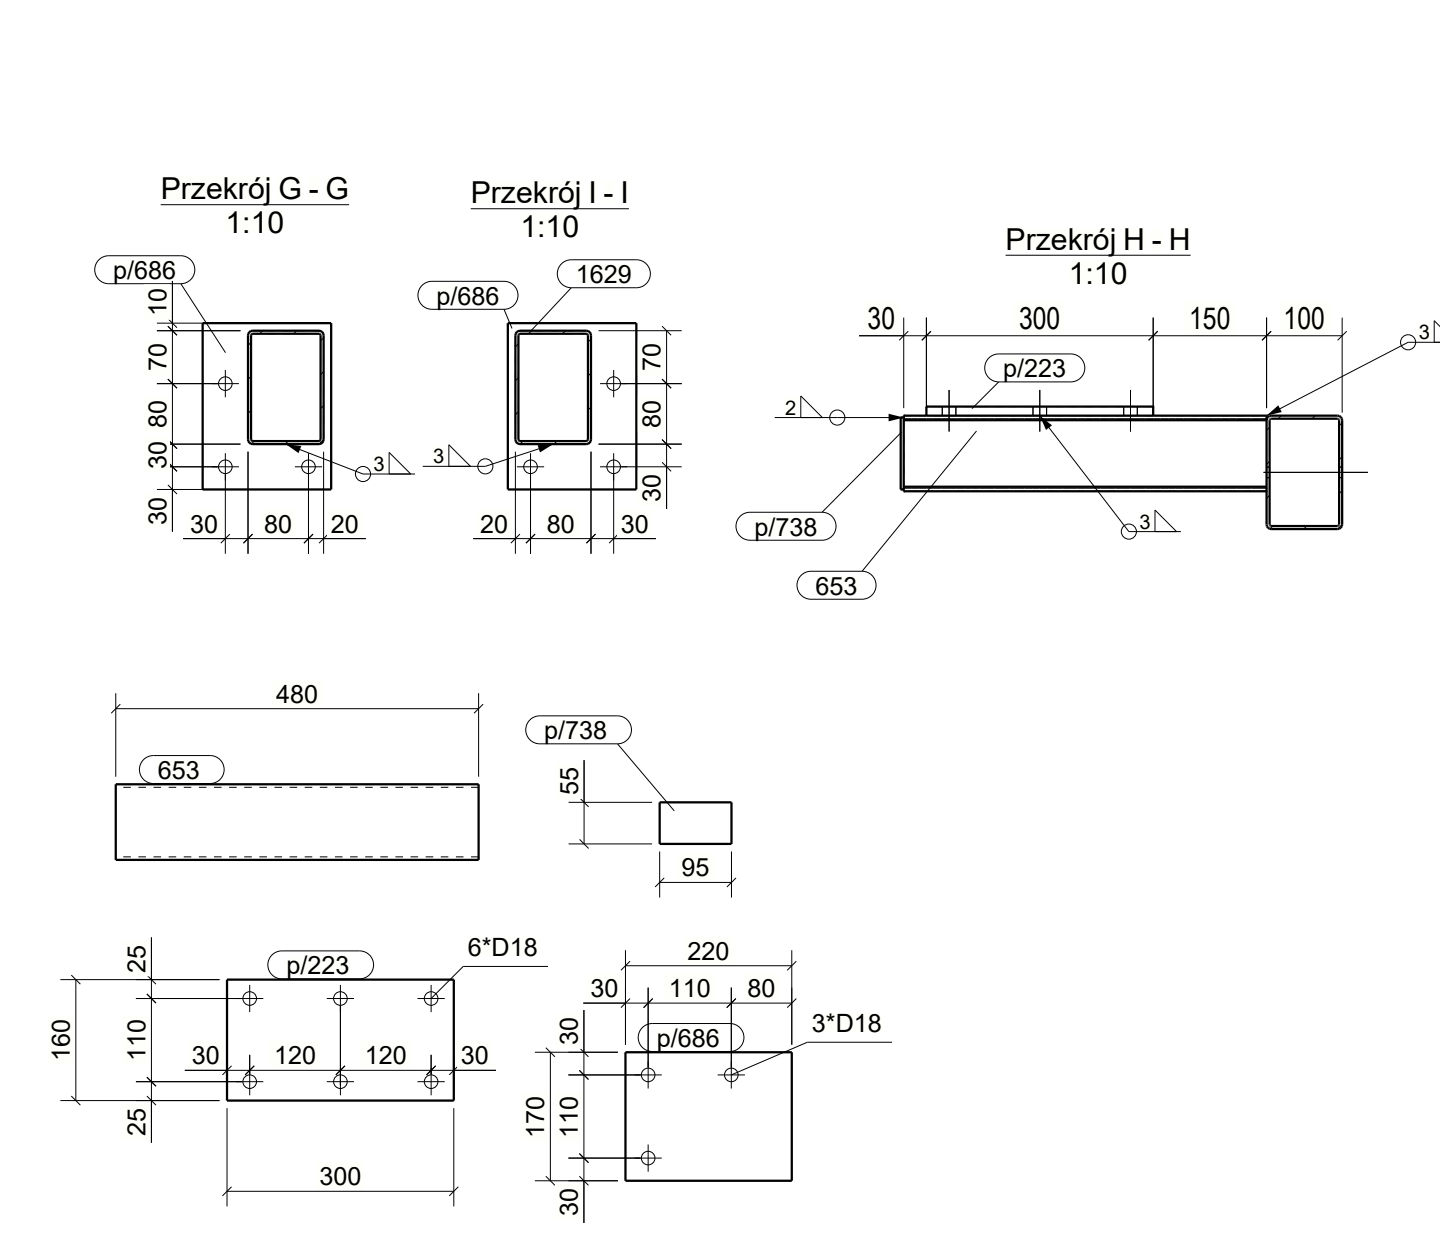
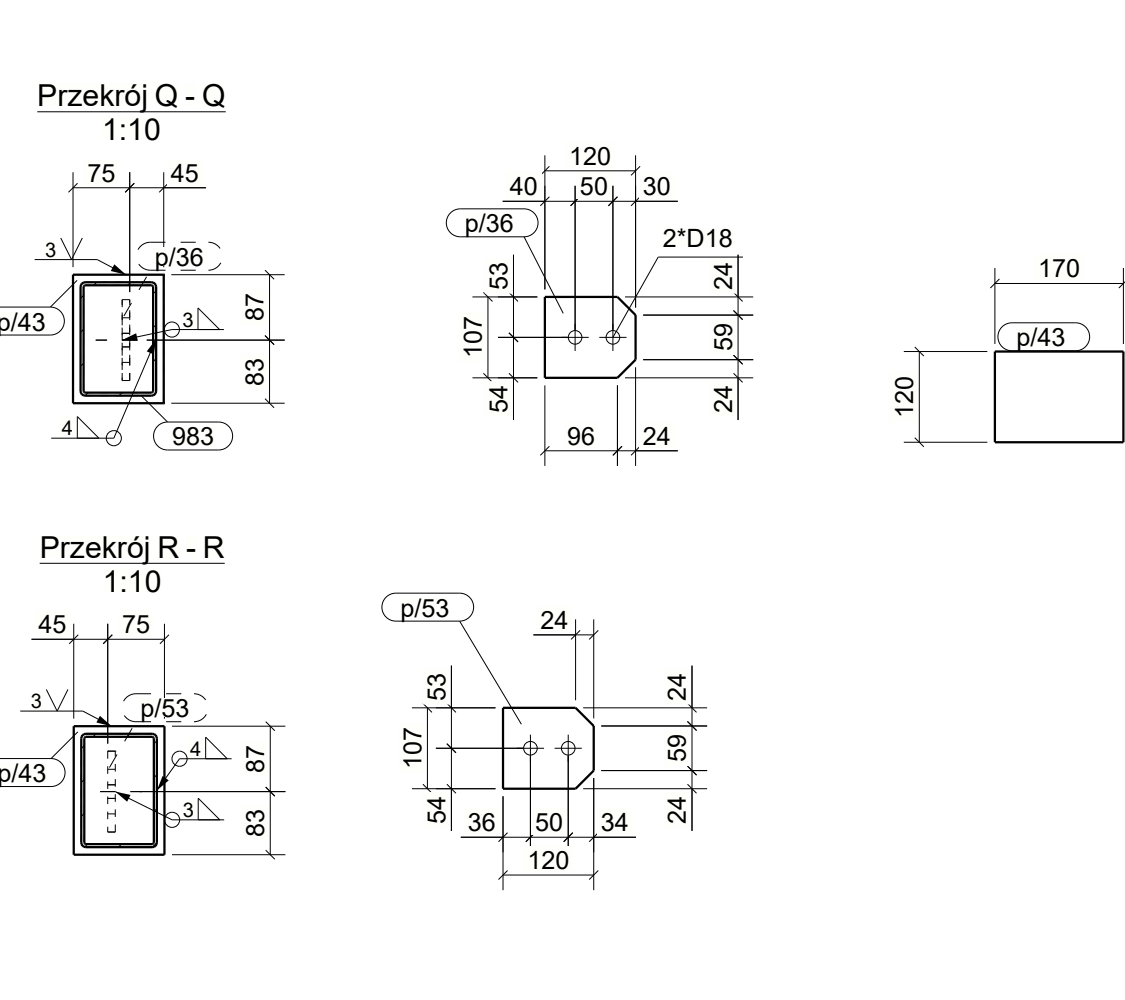


p36	BL10*107	S235JR	2	120	1.9
p43	BL10*120	S235JR	2	170	3.2
p4762	PL10*140	Steel U***	1	310	3.4

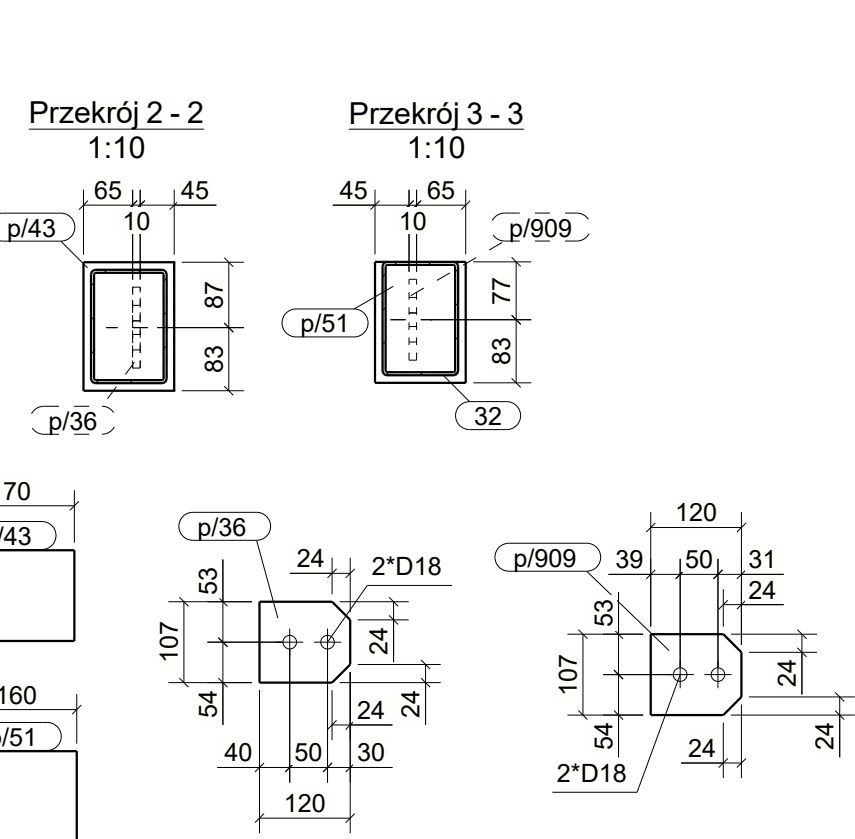

NAZWA PLIKU	ID REWIZ.
V-23_PW_N_K9_RYGLE ZESPOŁY_235	-