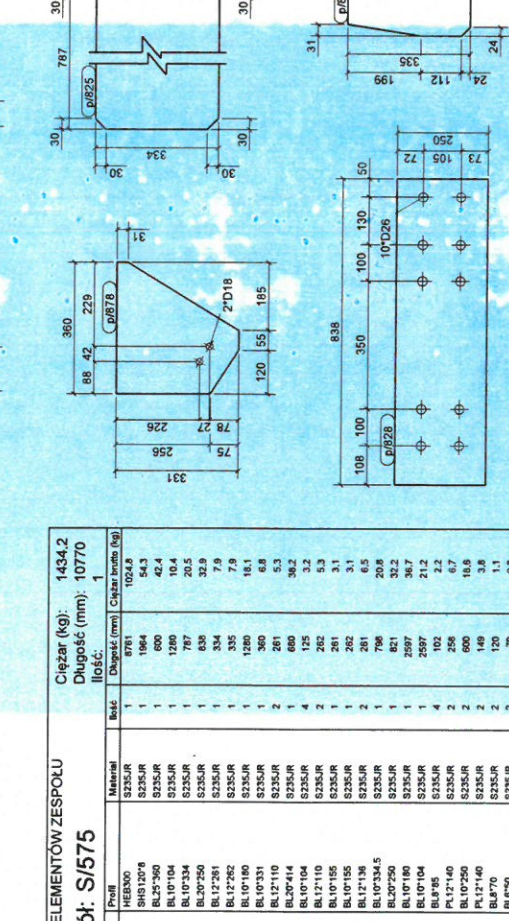
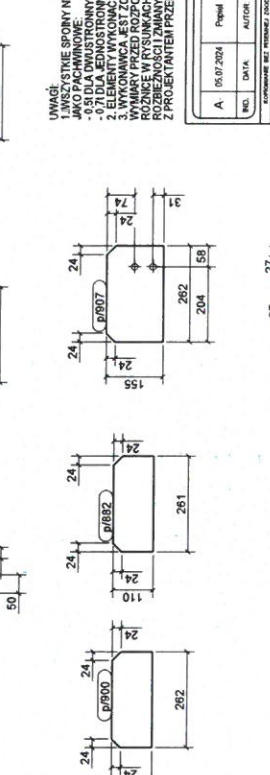
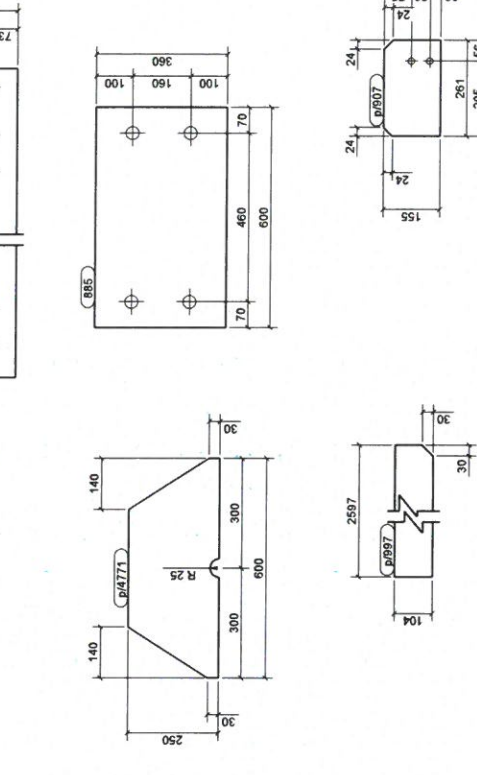
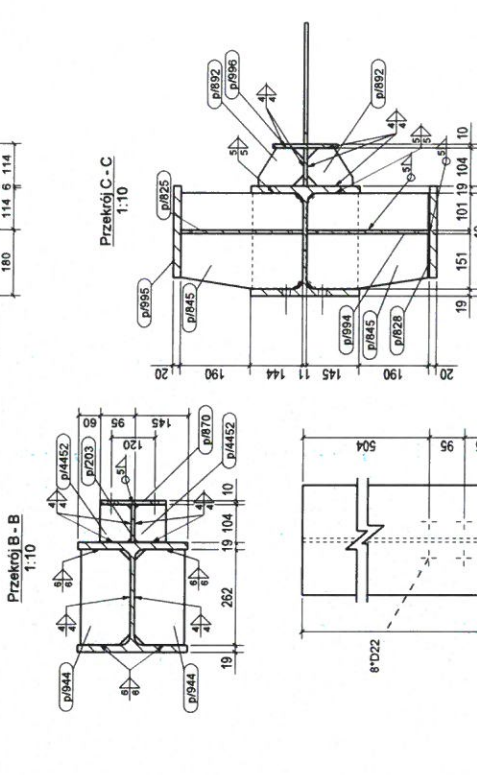
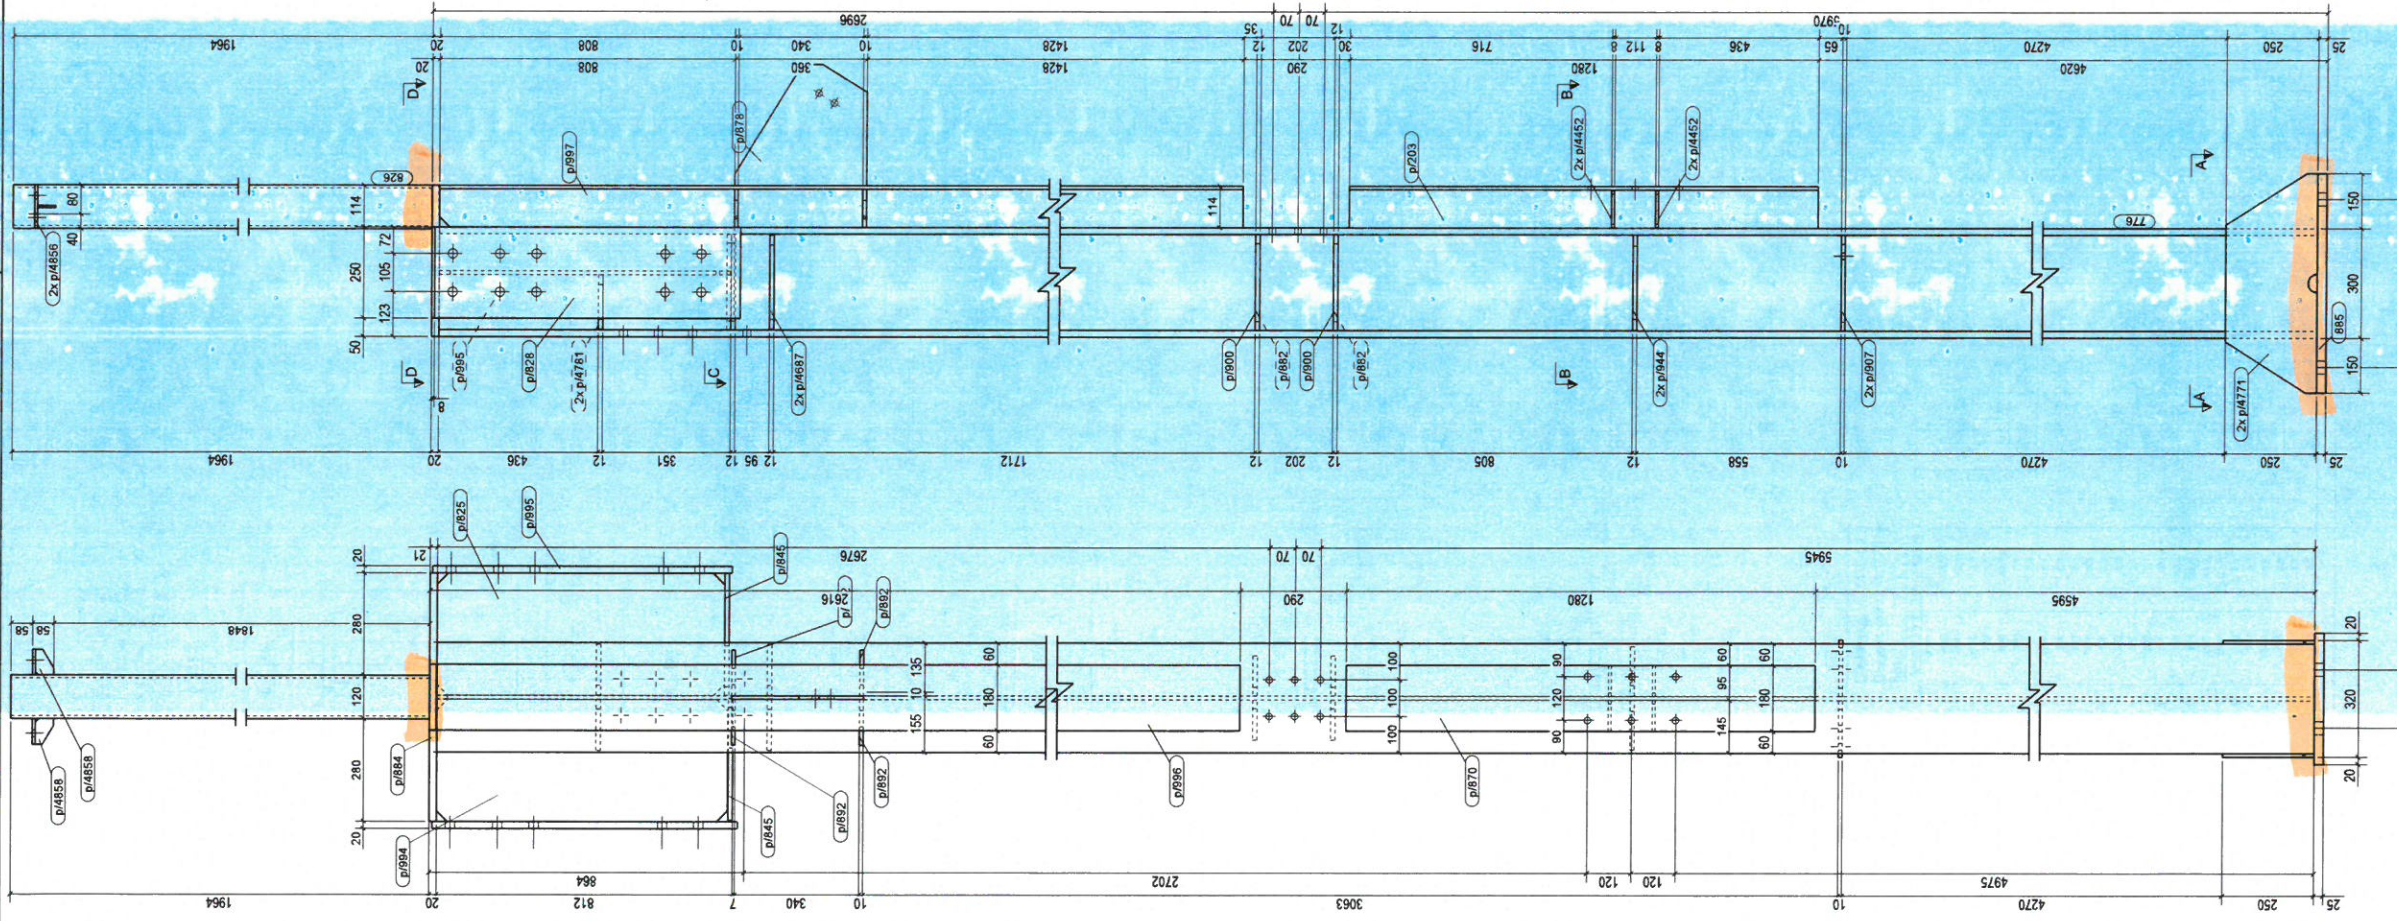


[illegible][illegible]

Wymiar	Element	Materiał	Ciężar brutto (kg)		Ciężar netto (kg)
			1	2	
7/8	HE8000	S235JR	1	8761	1024.8
8/8	SHS 120*9	S235JR	1	1964	54.3
8/8	SHS 120*9	S235JR	1	1960	42.4
p250	RL107104	S235JR	1	1280	10.4
p250	RL107104	S235JR	1	1280	10.4
p250	RL207260	S235JR	1	1917	20.5
p250	RL207260	S235JR	1	1917	20.5
p445	BL127361	S235JR	1	334	7.9
p445	BL127361	S235JR	1	335	7.9
p470	BL127361	S235JR	1	1280	18.1
p470	BL107180	S235JR	1	320	6.8
p478	BL107331	S235JR	1	281	5.3
p482	BL127110	S235JR	2	261	5.5
p482	BL127110	S235JR	2	260	38.2
p482	BL107104	S235JR	2	262	5.5
p4900	BL127110	S235JR	2	262	5.5
p4907	BL107155	S235JR	2	311	3.1
p4907	BL107155	S235JR	2	321	3.1
p4944	BL107155	S235JR	2	361	6.5
p4944	BL127345	S235JR	1	798	20.8
p4984	BL207345	S235JR	1	181	32.2
p4986	BL207345	S235JR	1	181	32.2
p4986	BL107104	S235JR	1	367	9.7
p4987	BL107104	S235JR	1	269	7.7
p4452	BL18195	S235JR	4	1027	2.2
p4452	PL121440	S235JR	2	358	6.7
p4687	BL107250	S235JR	2	500	18.6
p4771	BL107250	S235JR	2	149	3.8
p4781	BL127440	S235JR	2	128	1.1
p4908	BL48770	S235JR	2	128	1.1