
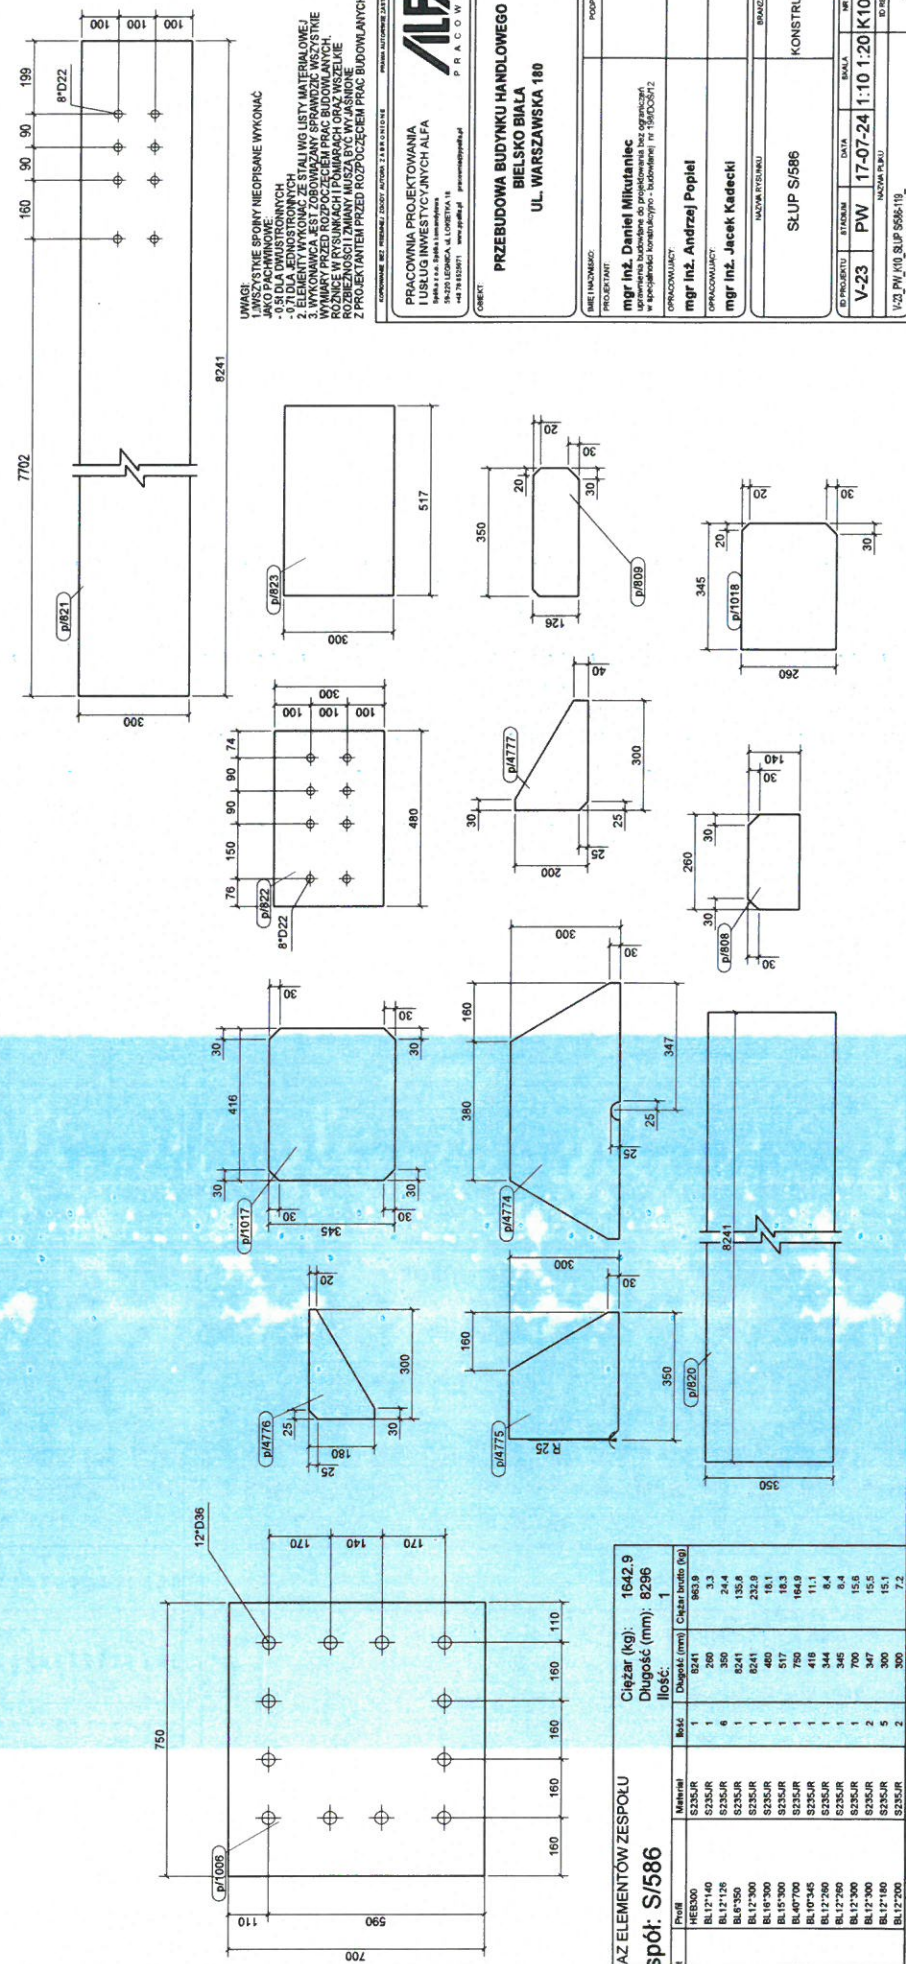


KRYSTIAN MICHNIEWICZ
Specjalista
CERT. VT, PT POZIOM 2
Nr IC/NDT/4546 WG PN-EN ISO 9712
nadane przez IS Gliwice

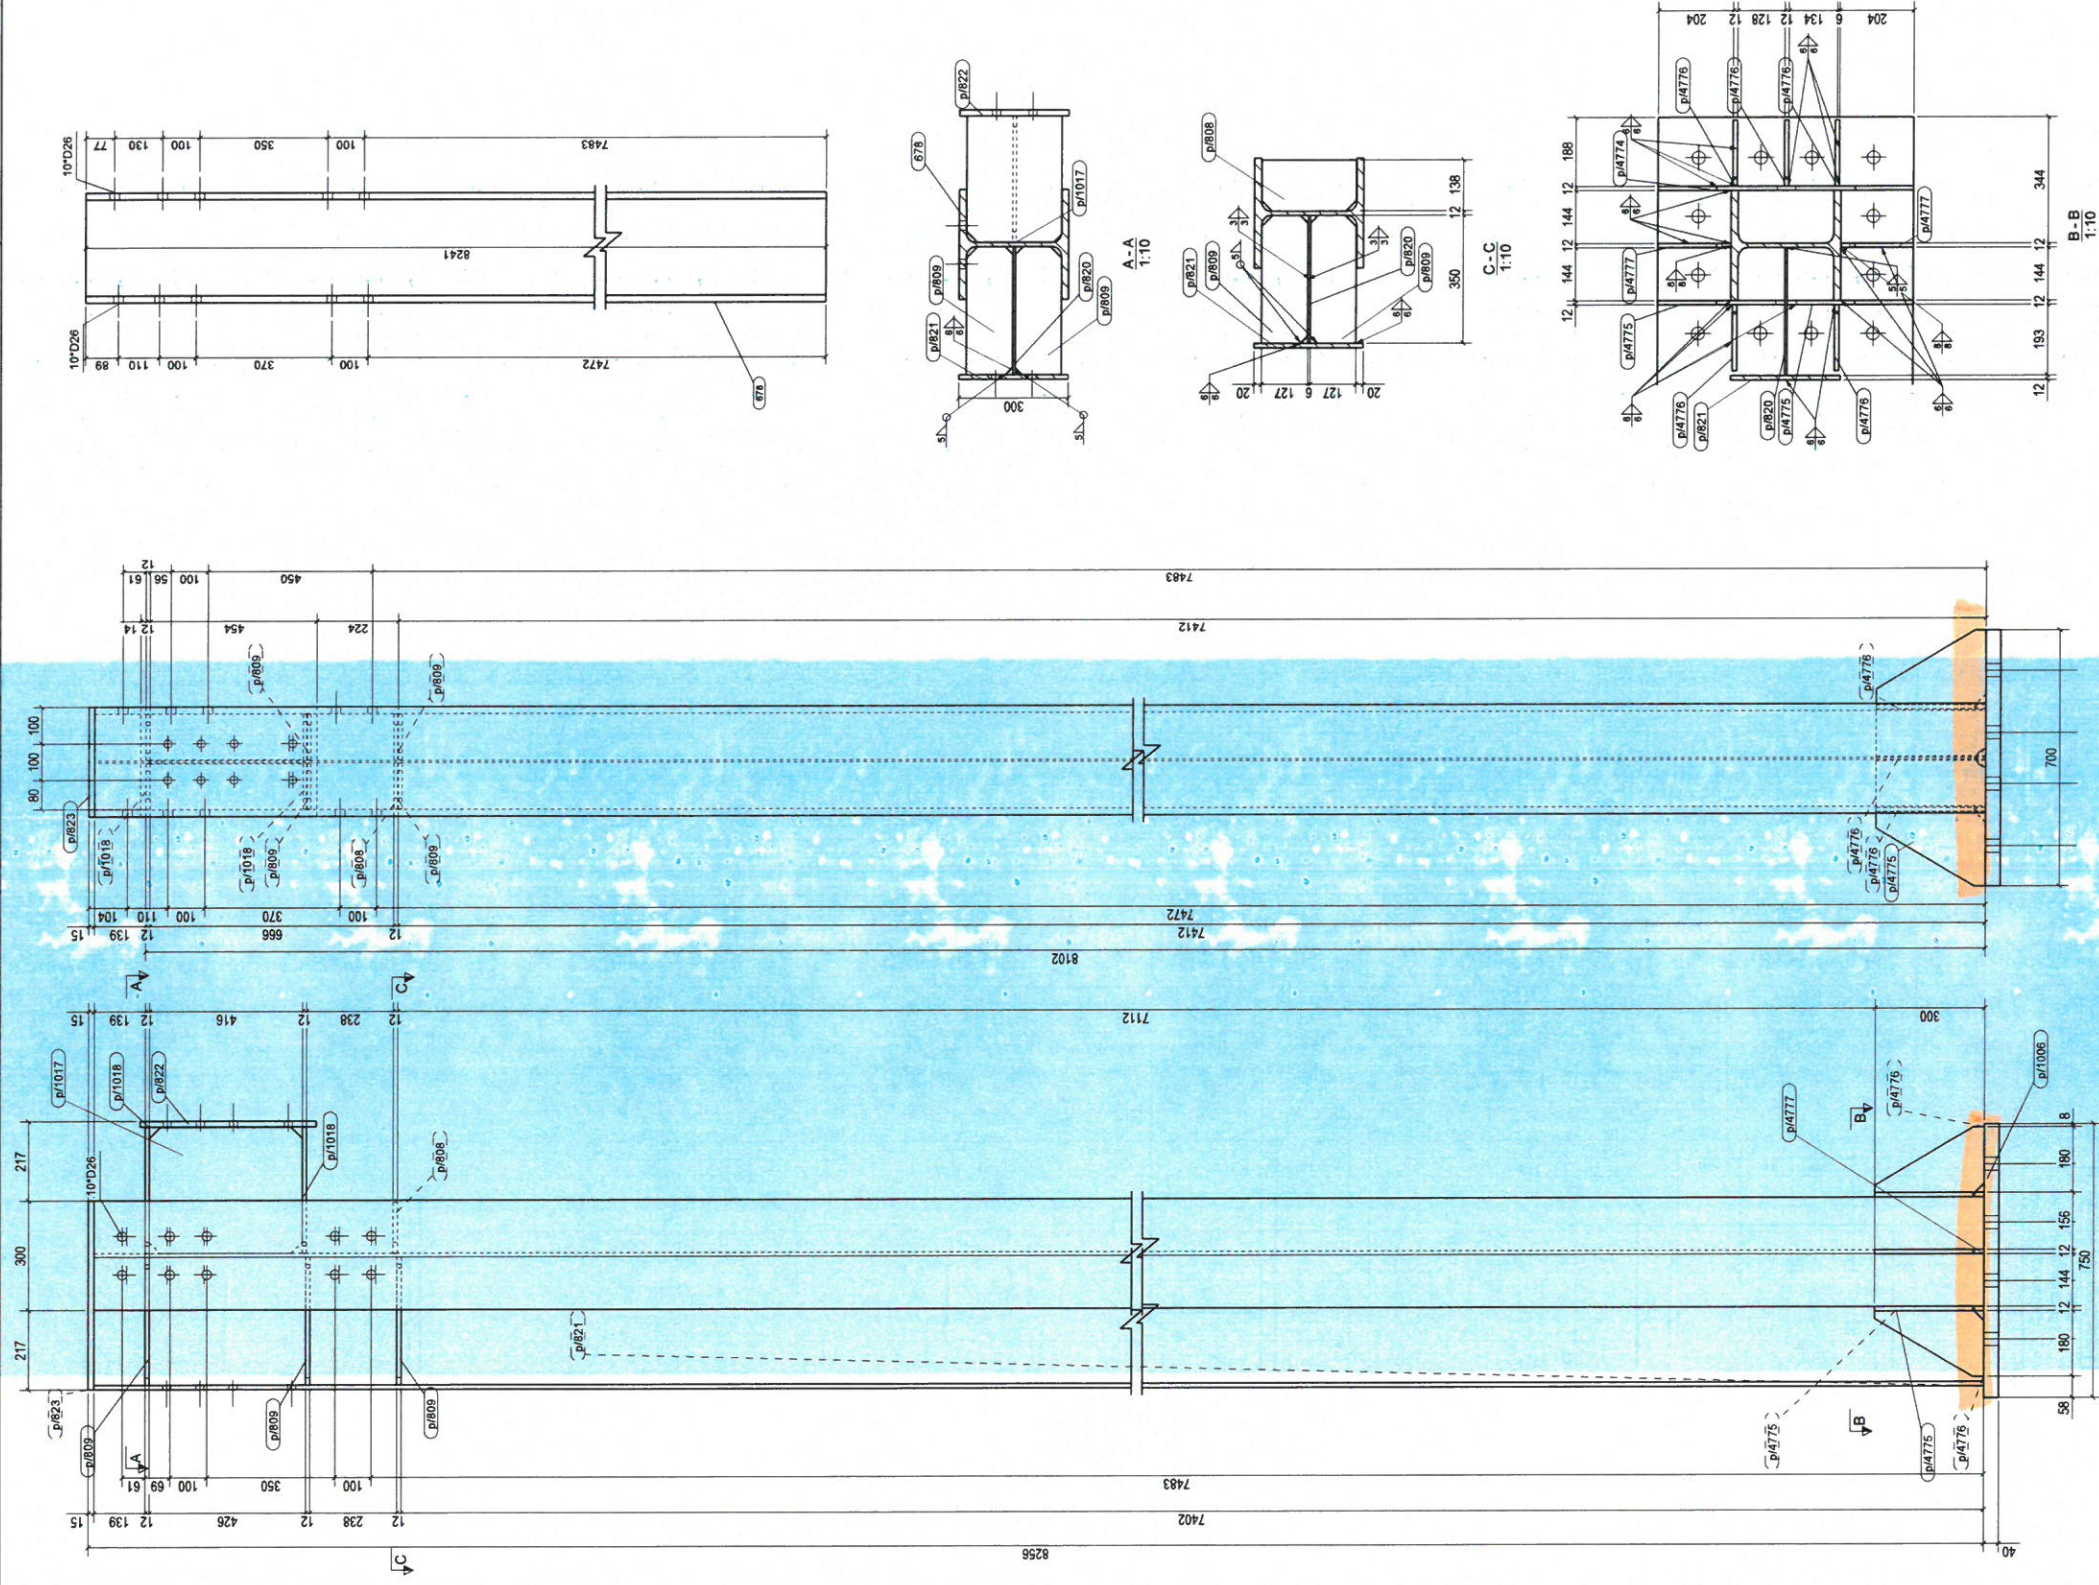

WYKAZ ELEMENTÓW ZESPÓŁU		Zespół: S/586		Ciezar (kg): 1642,9	Długość (mm): 8296	Ilość: 1
Element	Material	Bolek	Długość (mm)	Ciezar brutto (kg)		
678	HF8300		5353R	1	5241	863,9
p008	BL12140		5353R	1	260	3,3
p009	BL12146		5353R	6	350	24,4
p010	BL12150		5353R	1	350	24,4
p021	BL12190		5353R	1	8541	232,1
p022	BL12190		5353R	1	8541	232,1
p023	BL15700		5353R	1	640	18,1
p024	BL15700		5353R	1	517	18,3
p006	BL40700		5353R	1	790	164,9
p017	BL10745		5353R	1	4018	11,1
p018	BL12760		5353R	1	344	8,4
p019	BL12760		5353R	1	345	8,4
p076	BL12700		5353R	2	347	15,5
p077	BL12700		5353R	2	347	15,5
p078	BL12760		5353R	5	300	15,1
p0777	BL12700		5353R	2	300	7,2

10.1111/j.1365-3113.2011.04511.x